



**2** Permitted Ground Floor Plan

1 : 50

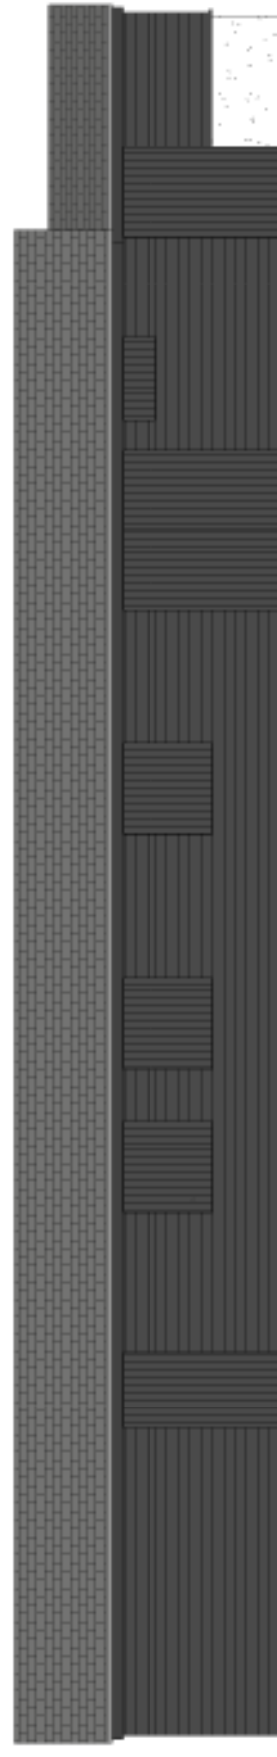


**3** Permitted Front Elevation

1 : 100

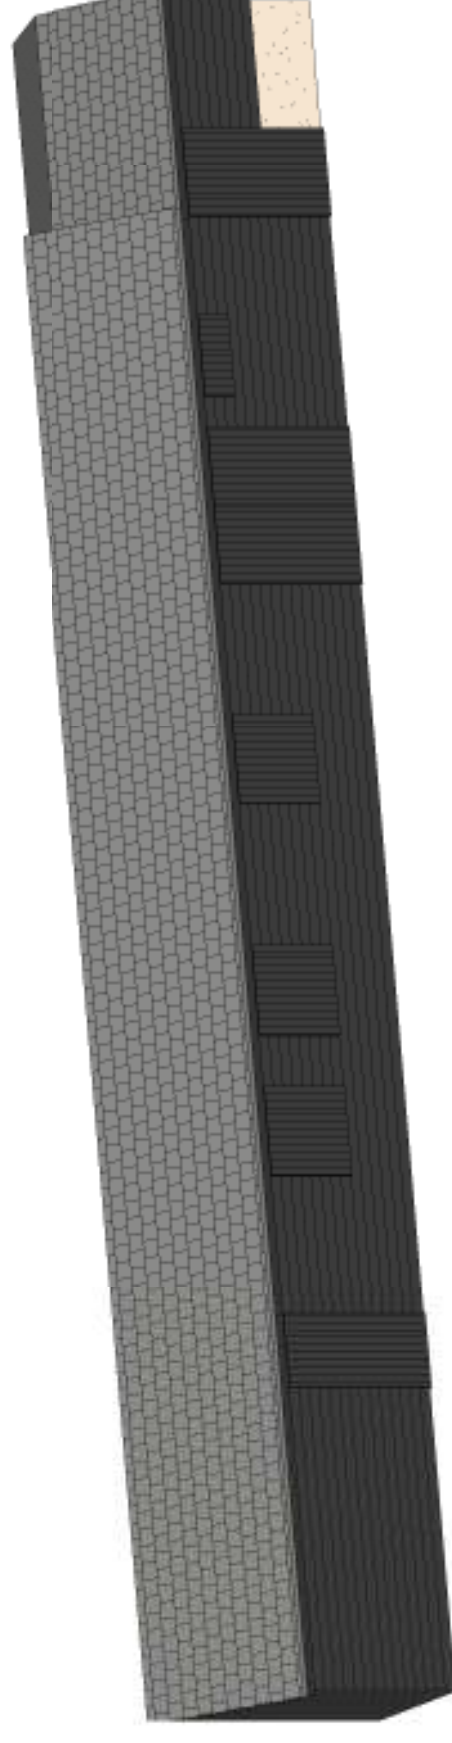

**6** 3D View Front


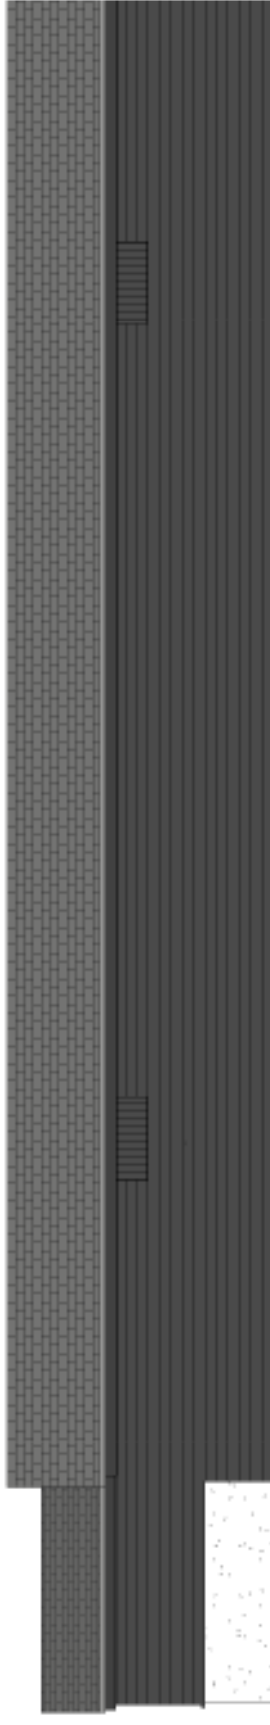


**1** Permitted Rear Elevation

1 : 100


**PROPOSED WORKS**

New detached building comprising 2 letting units.  
Construction  
Feather edge board to match the existing building on site.  
Timber shutters over the windows and doors to match the existing building and maintain the agricultural appearance.  
Pitched roof with natural slate tiling.

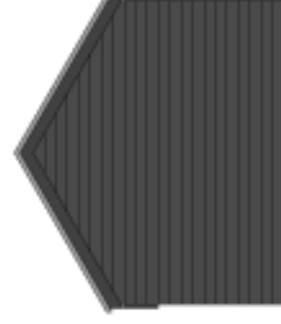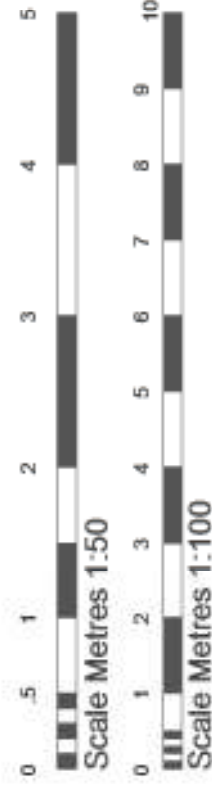

**5** Permitted Side (Left) Elevation

1 : 100

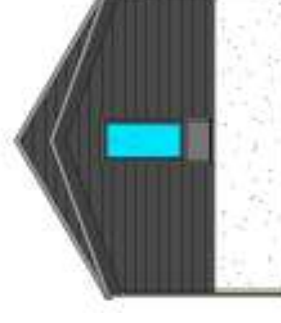

**4** Permitted Side (Right) Elevation

1 : 100

Drawings by:

**unsted design**

3D Computer Aided  
Architectural Design

Unsted Design Ltd  
16 Hazel Close,  
Enderby Road,  
SOS5 5RF  
Tel: 02380274720  
Fax: 02380274720  
Email: info@UnstedDesign.co.uk  
Web Site: www.UnstedDesign.co.uk  
Company Number 8013235

**Revision**

**Utilities/Highways/Environment:** It is the responsibility of the client or their contractor to liaise with the Utility providers, Highway Authorities and Environment Agency to ensure that all approvals are in place unless Unsted Design have been given written instructions to act on your behalf.  
**Copyright:** The copyright for this drawing remains the property of Unsted Design. It cannot be copied, altered or reproduced in any form without the written consent of Unsted Design.  
**Dimensions:** All dimensions to be checked on site prior to the commencement of any work. Do not scale from this drawing for construction purposes.  
**Party Wall Agreements:** It is the sole responsibility of the building owner or their contractor to draw up any agreements or notices required to comply with the Party Wall Act. This drawing does not guarantee the position of the boundary.

**Client:** MR SCOTT BUNDY  
**Project Address:** LONG BARN  
SADLERS MILL FARM  
THE CAUSEWAY  
ROMSEY  
SO51 8HF

**Drawing Contents:** AS BUILT FLOOR PLANS, ELEVATIONS  
3D VIEW.

**Purpose:** PLANNING APPLICATION

**Scale:** 1:50 1:100

**Date:** 12th May 2020

**Drawn by:** MKU

Number: 002 BUNDY  
Sheet: 002 BUNDY  
Revision: PR1165 A2