



15.00m Datum

Elevation 1

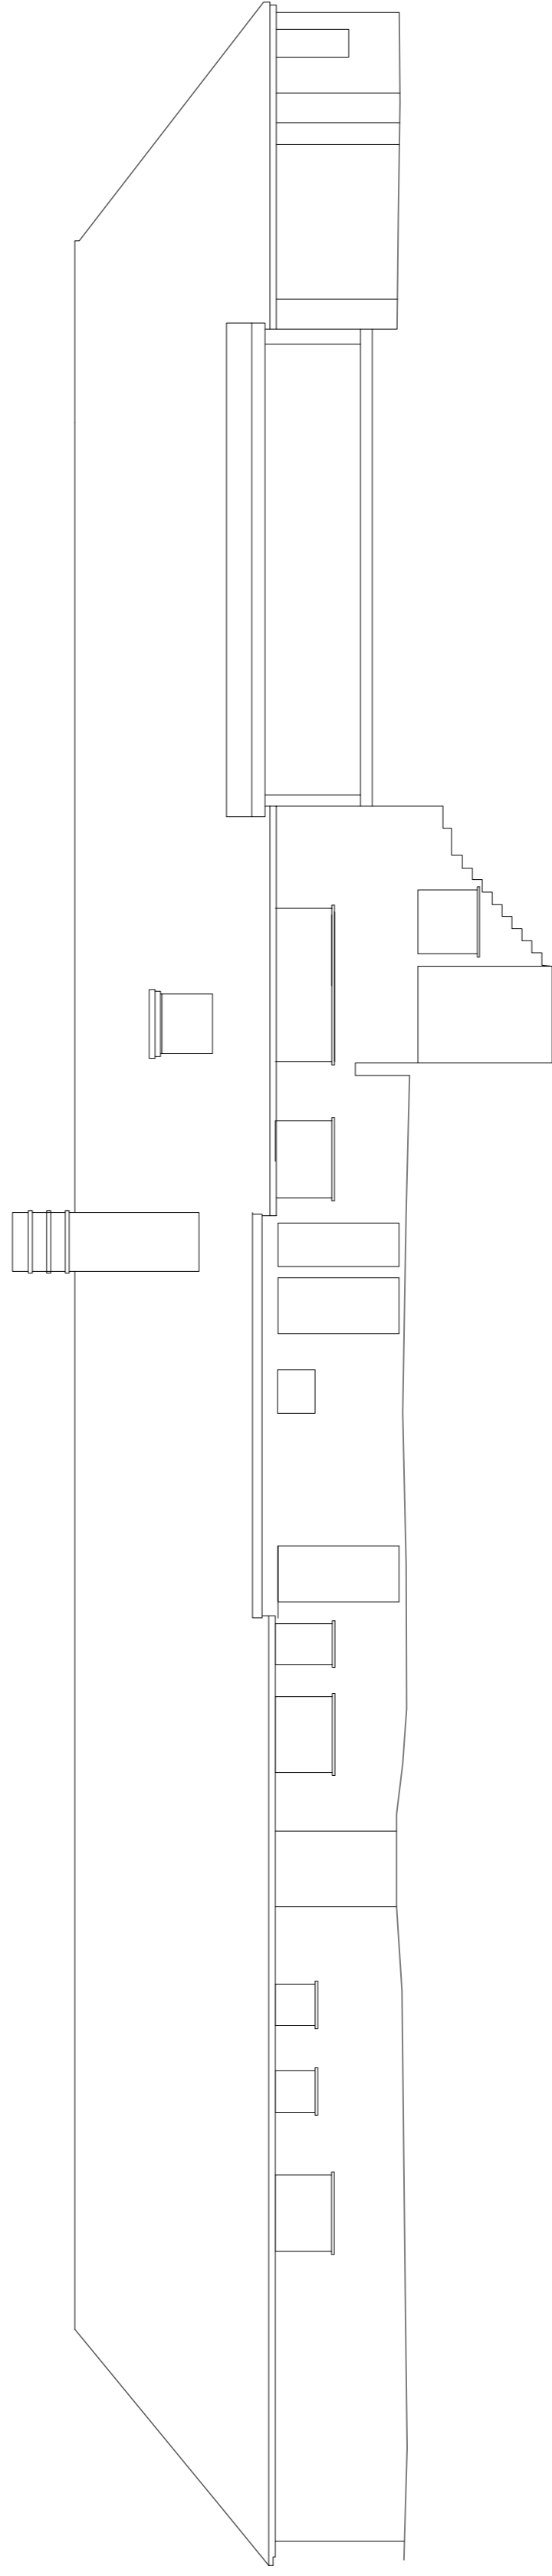


13.00m Datum

Elevation 2

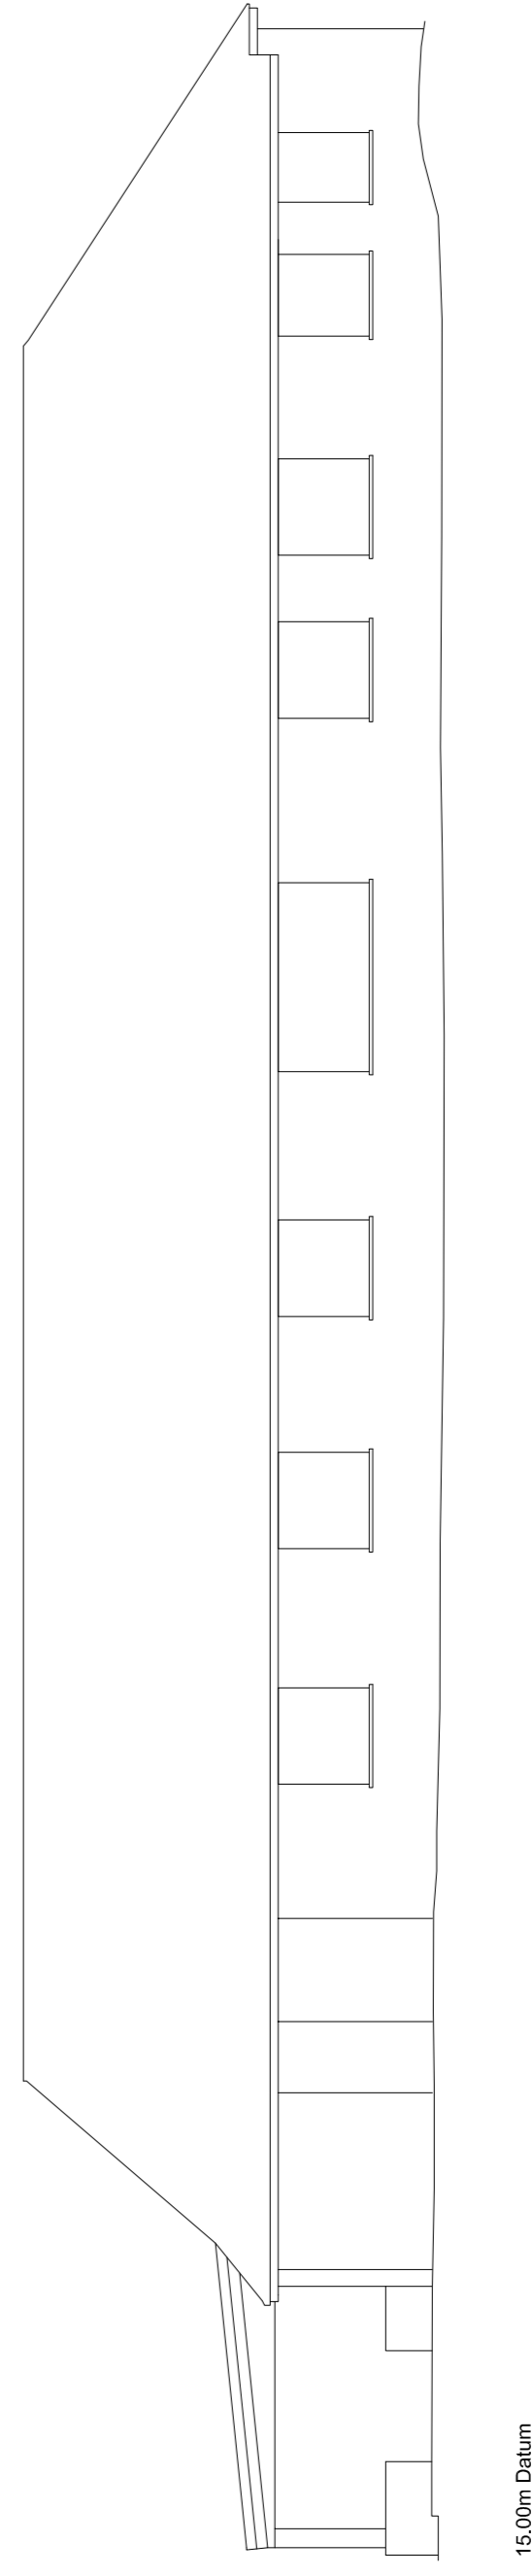

15.00m Datum

Elevation 3

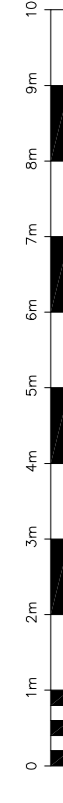

Scale 1 : 100

D&H Surveys

The Manor Stable, Great Somerford, Clipperton
 Wiltshire, SN15 5BH
 Email: admin@dhsurveys.co.uk Tel: (01249) 720545
 Website: www.dhsurveys.co.uk Fax: (01249) 721124

Topographic Surveys
 Elevation Surveys
 Photogrammetry
 Volume Surveys
 As Built Drainage Surveys
 Site Setting Out
 Coordination Of Site Layouts
 Excavation Elevations
 Road Profile Elevations
 C.A.D Plotting Bureau

Project Name:

Edwina Mountbatten House
 Romsey

Drawing Title:

Elevations 1-3

Client:

Planning Issues

Agent:

Date:

Feb 2023

Scale:

A1 @ 1:100

Drawn

KJH

Surveyor

SCB

Dwg No

EL 02

Revision

Site Datum

OS

OSBM Reference

Grid Orientation

Arbitrary

Sheet ID

CHURCHILL-Romsey-Edwina

Disclaimer

D & H Surveys will guarantee that this
 Survey Data is correct to the Indicated
 Scale only.